



LOT E & F
65,308 SF

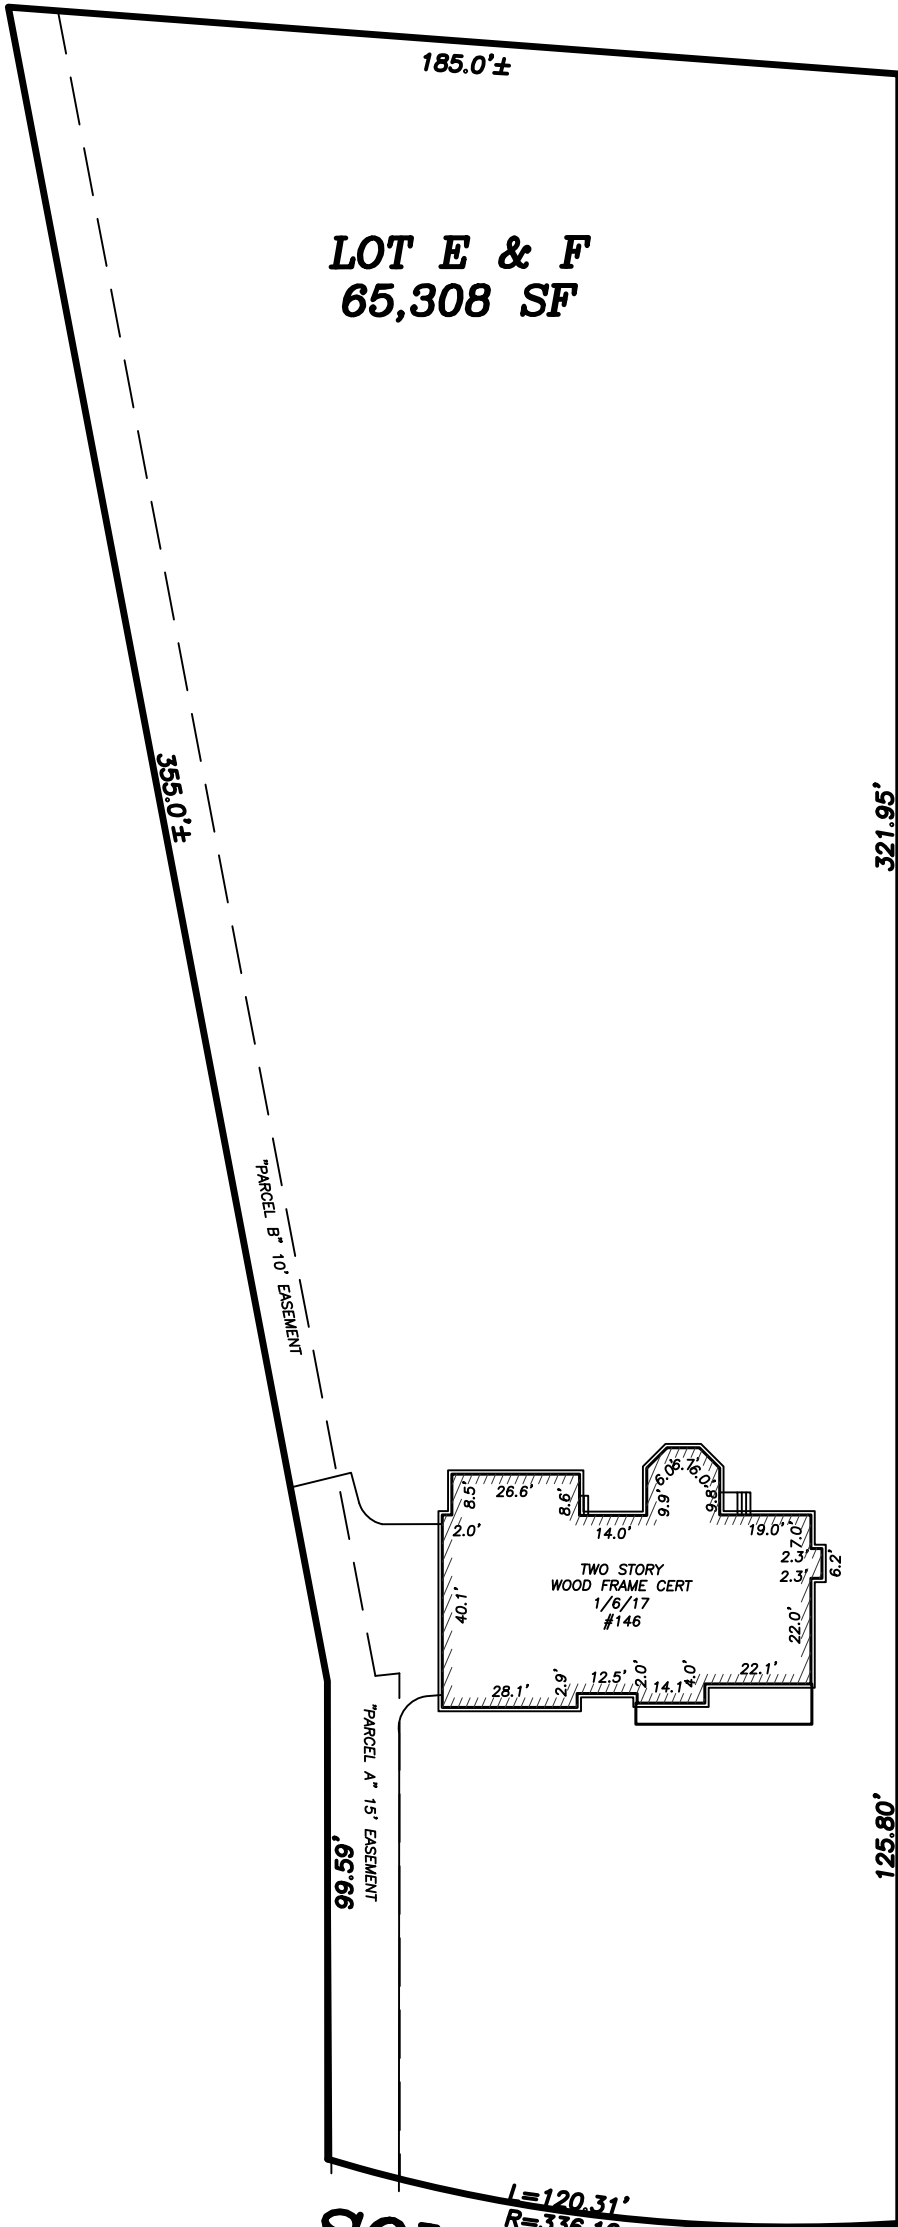

SOUTH STREET

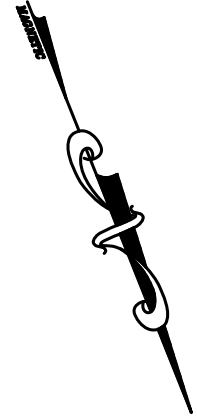

FINAL AS BUILT
146 SOUTH STREET
NEEDHAM, MA

Field Resources, Inc.
LAND SURVEYORS



JANUARY 6, 2017 SCALE 1"=40'
P.O. BOX 324 281 CHESTNUT ST.
AUBURN, MA NEEDHAM, MA.
508 832 4332 781 444 5936
fieldresources@hotmail.com